


WESTSHORE CORPORATE CENTER

600 N. Westshore Boulevard, Tampa, FL 33609

Floor 2:

FULL FLOOR AVAILABLE: 12,029 RSF

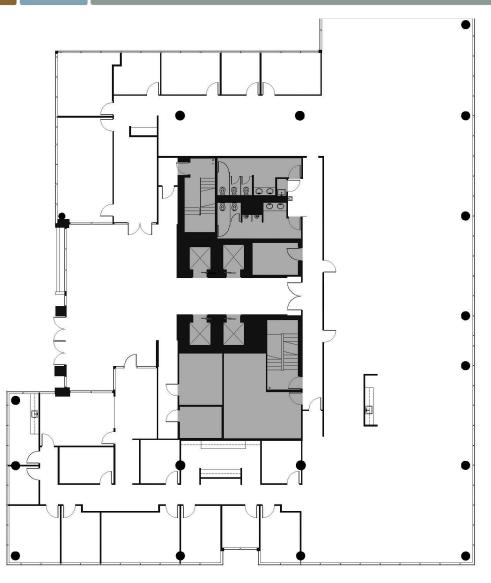

Clay Wommack

Clay.Wommack@FranklinSt.com 813.345.5886

Matt Alexander

Matthew.Alexander@FranklinSt.com 813.559.2006

Franklin Street

600 N. Westshore Blvd, Suite 600, Tampa, FL 33609 Licensed Real Estate Broker

PLAN NOT TO SCALE

No warranty of representation, expressed or implied, is made to the accuracy of information contained herein, and same is submitted subject to errors, change of price, rental or other conditions, withdrawal without notice, and to any special listing conditions imposed by our principals.