


**Suite 701: 1,980 RSF**

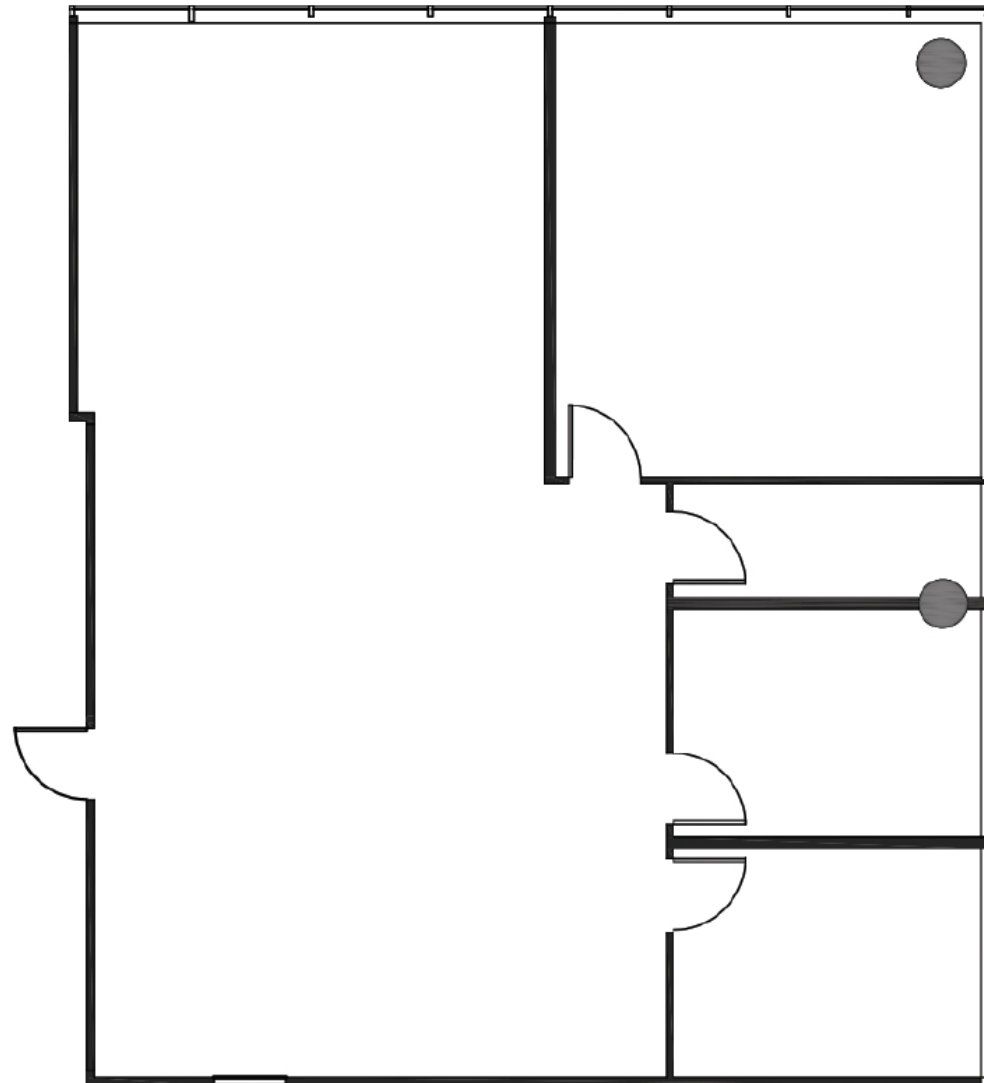

**Franklin Street**

600 N. Westshore Blvd, Suite 600, Tampa, FL 33609

Licensed Real Estate Broker

**PLAN NOT TO SCALE**

**Clay Wommack**

Clay.Wommack@FranklinSt.com

813.345.5886

**Matt Alexander**

Matthew.Alexander@FranklinSt.com

813.559.2006

No warranty of representation, expressed or implied, is made to the accuracy of information contained herein, and same is submitted subject to errors, change of price, rental or other conditions, withdrawal without notice, and to any special listing conditions imposed by our principals.