


Floor 9:

**FULL FLOOR AVAILABLE:
16,725 RSF**

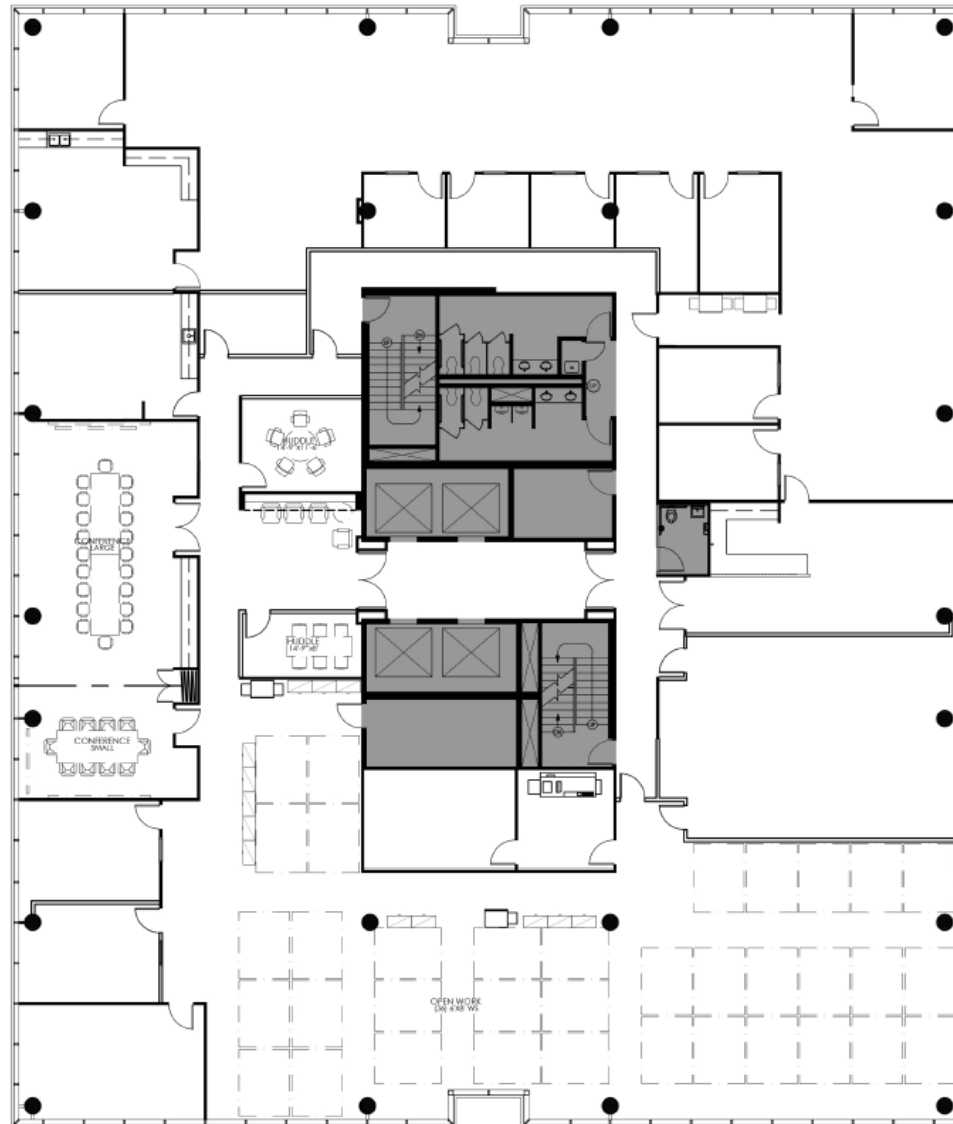

Franklin Street

600 N. Westshore Blvd, Suite 600, Tampa, FL 33609

Licensed Real Estate Broker

PLAN NOT TO SCALE

No warranty of representation, expressed or implied, is made to the accuracy of information contained herein, and same is submitted subject to errors, change of price, rental or other conditions, withdrawal without notice, and to any special listing conditions imposed by our principals.

Clay Wommack

Clay.Wommack@FranklinSt.com

813.345.5886

Matt Alexander

Matthew.Alexander@FranklinSt.com

813.559.2006